



2-2

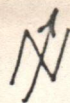

N1W2

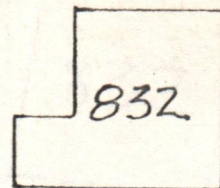

ALLEY

6" C.I.

23.0'

34.0'

2" C.I.

SUTHERLAND DR.

T.P. $\varnothing$ 4.0'

4.0'

