


3-1

N1W2

SUTHERLAND DR.

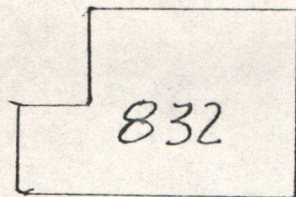

GRASS ALLEY

FENCE

