



0103

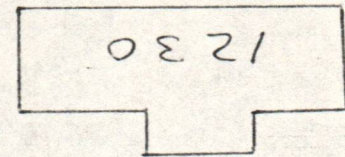

Highland

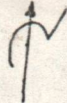

43.3


22.0

7.9

7.5

12.21

7.2K
1.5M.L

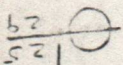

19-1