

W1W3


8-1



Central.

Av

E

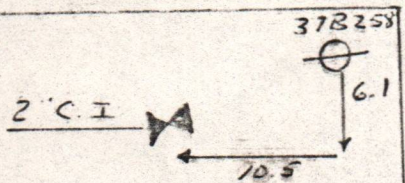

W13



19.0