


N2E1

3-1



25

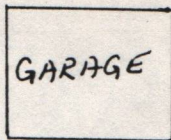

ALLEY

8" C.L.



6.9'

3.0'

19.3'

13.5'

WEST

