


12-2

N2E2

TO WILSON

ALLEY

CHESTNUT

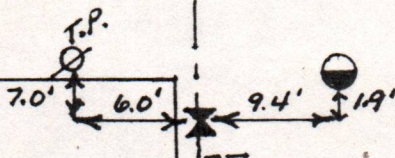

TO LINCOLN