

22-2


N2 E2

TO WASH.
AVE. ↗

STREET

6" C.I.

ALLEY

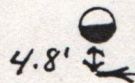

4.8'

29.9'

15.9'

11
36'

8.6'

521

WALNUT

TO MONROE ↘