

22-3

TO WASH. AVE.



N2E2


STREET

ALLEY



6.4'

33.4'

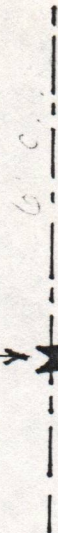

12.1'

$\frac{1}{2}$
 $\frac{3}{4}$
 $\frac{1}{11}$

10.2'

TO MONROE

WALNUT