

7-2




N2E2

LINE

LINCOLN AVE.

ALLEY

Ø T.P.

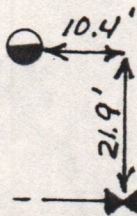

8" c.l.

60.6'

11.1'

2301