
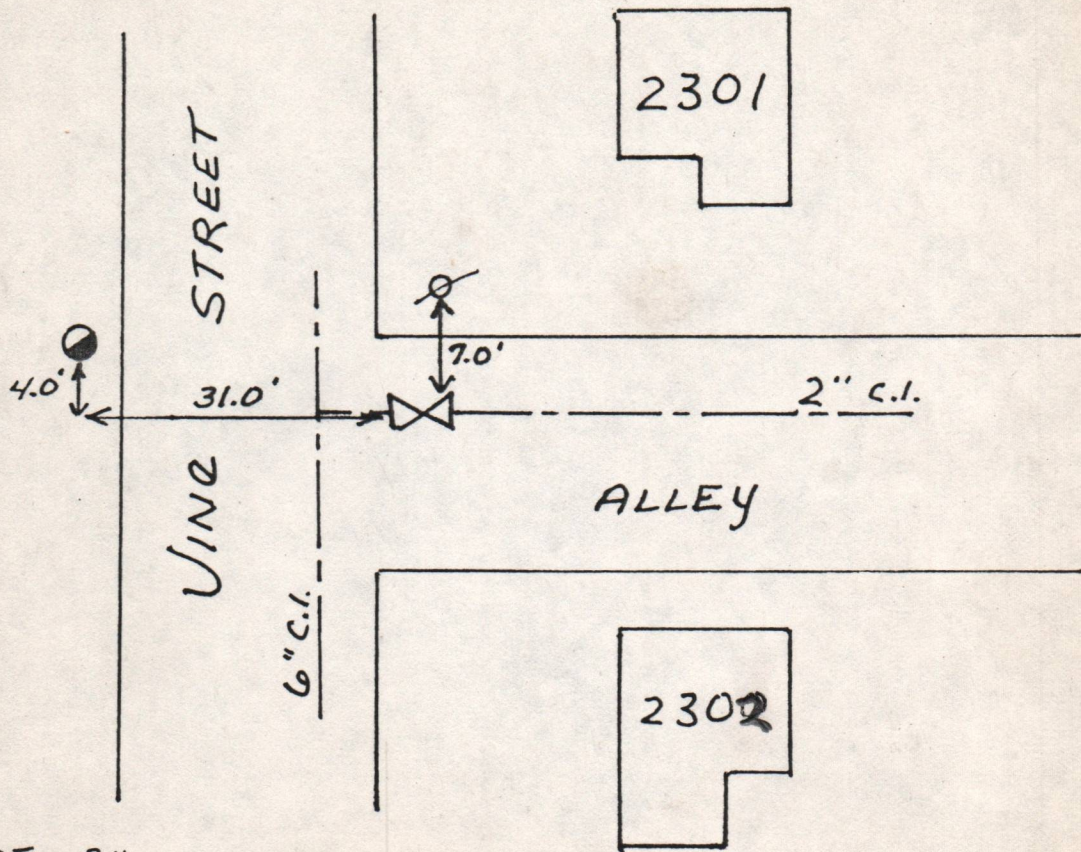


7-3

TO LINCOLN

N2E2

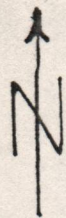

CANT LOCATE - 2" c.i.

TO WASHINGTON AVE.