


N 2 E 3

FURLONG



2-1

PEAFE STREET

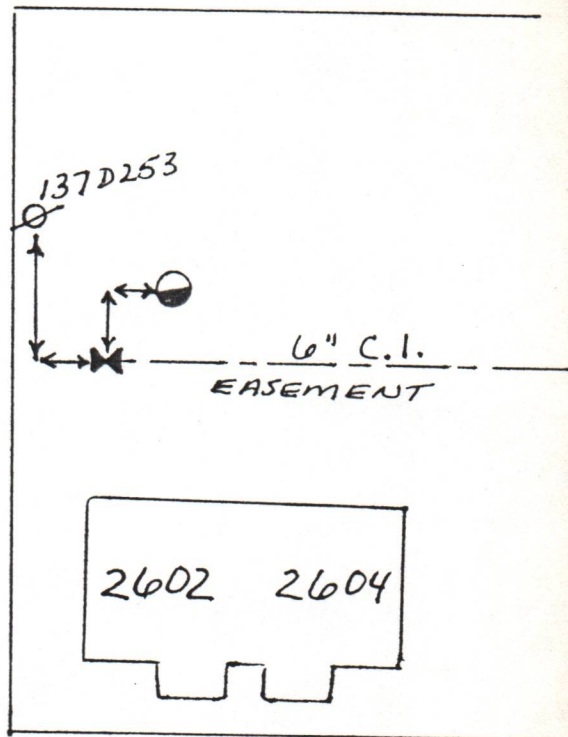

MORRELL