


N2E3

22-1



WILLOW ST

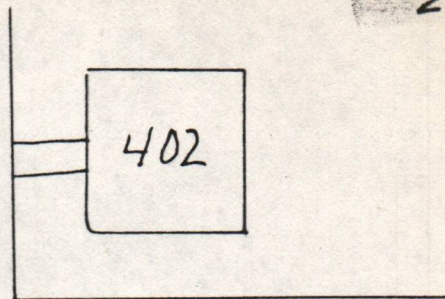

LINCOLN

AVENUE

