


N2E3

FORRESTAL

6-1

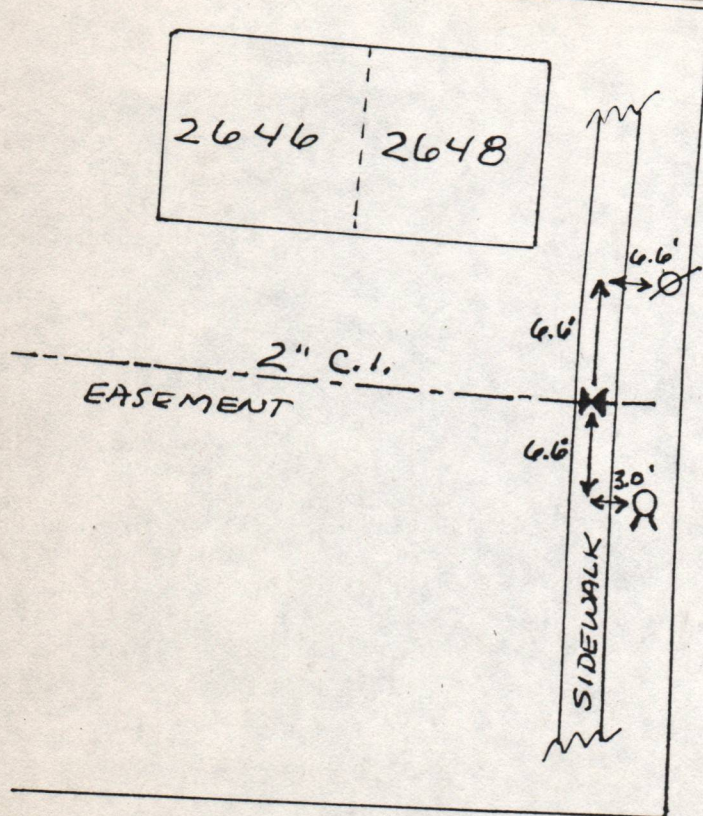

DE CHARMES

BARD

AVENUE