


10-1

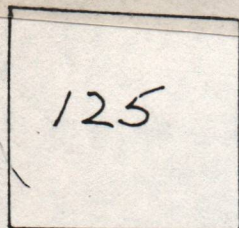

25.0'

T.P.

4.0'

10.0'

2 1/4" C.I.

2.6'

2 1/4" C.I.



N2E4

CLAREMONT

AVENUE

OAK ST.