


15-1

BARD AVE



N2E4

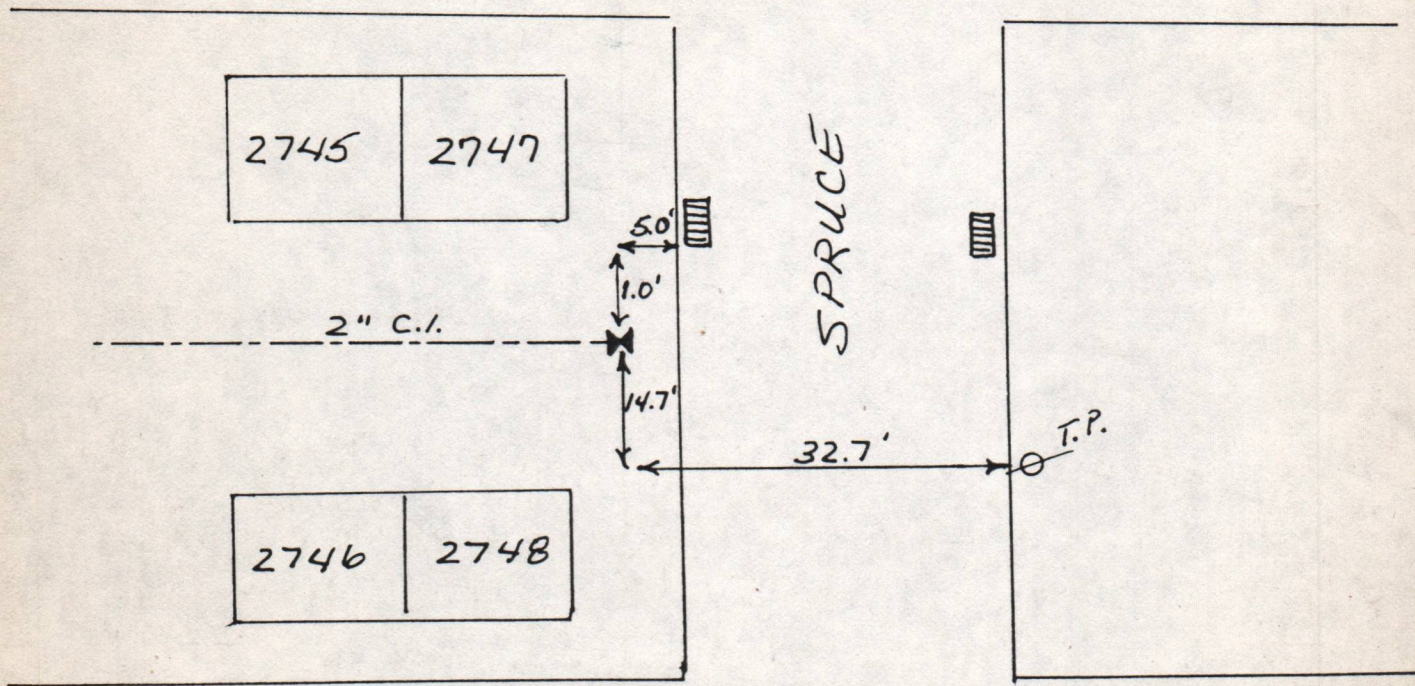

FURLONG AVENUE