


15-2

FURLONG



N2E4

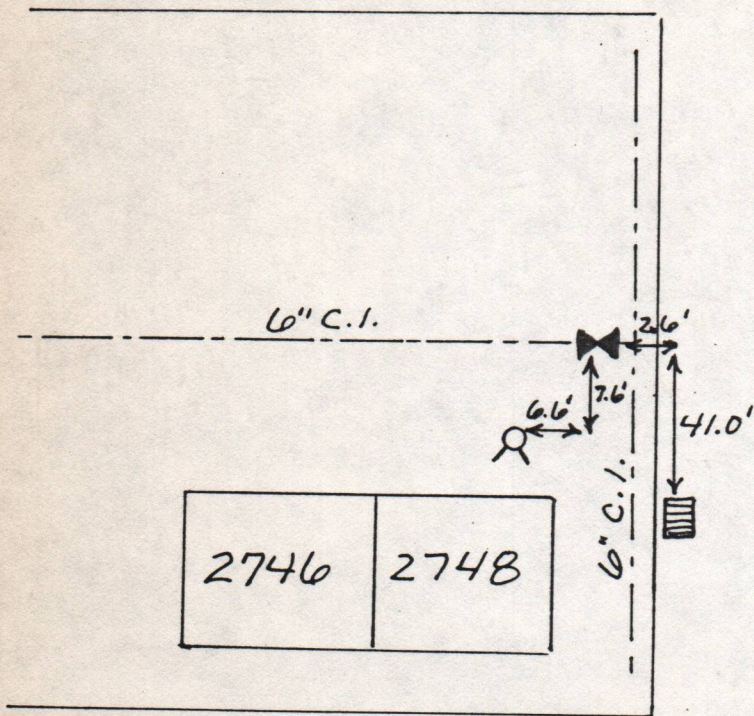

SPRUCE ST.

MORRELL AVENUE