



17-1

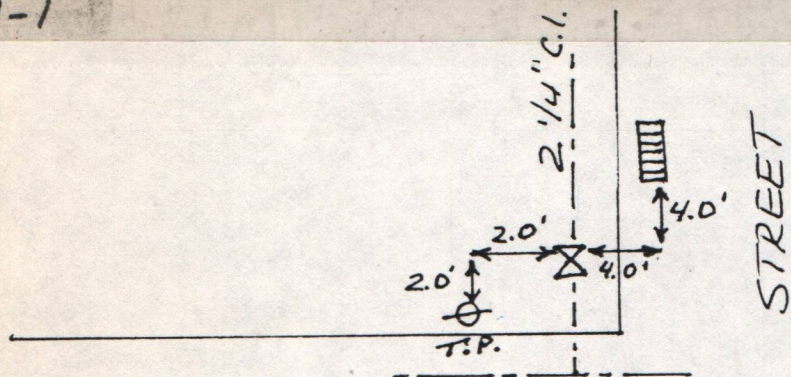

CLAREMONT

AVENUE

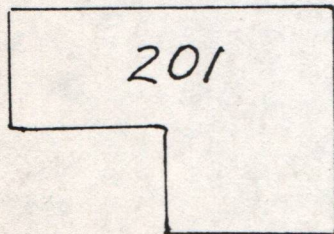

ALAMEDA

N2E4

