


21-1

N2E4

302

MORRELL

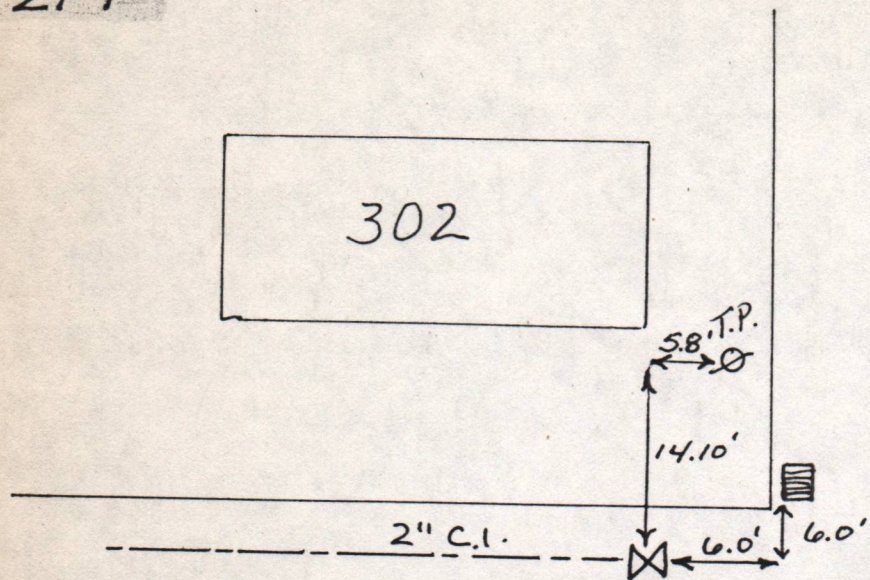

SPRUCE

BERKLEY

