


N2W1



10-1

SEVENTH AVENUE

E

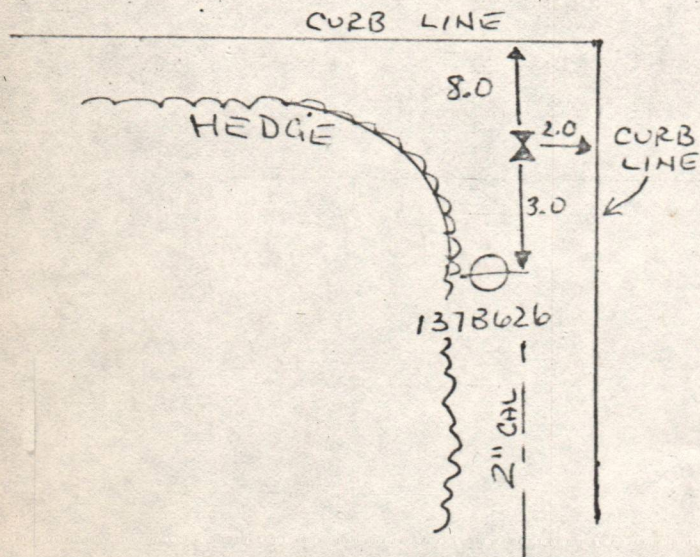

KASICK DRIVE

