


19-1

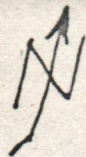

CHURCH
PARKING

8" C.I.

KANAWHA TERRACE

BAIER ST.

HANSFORD

N2W1

1804

