


N2W1

20-1

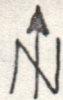

CHURCH
PARKING

6" C.I.

HANSFORD

1804

137B210



14.0

9.8

22.5

CENTER
LINE

KANAWHA TERRACE

BAIER