


20-4

N2W1

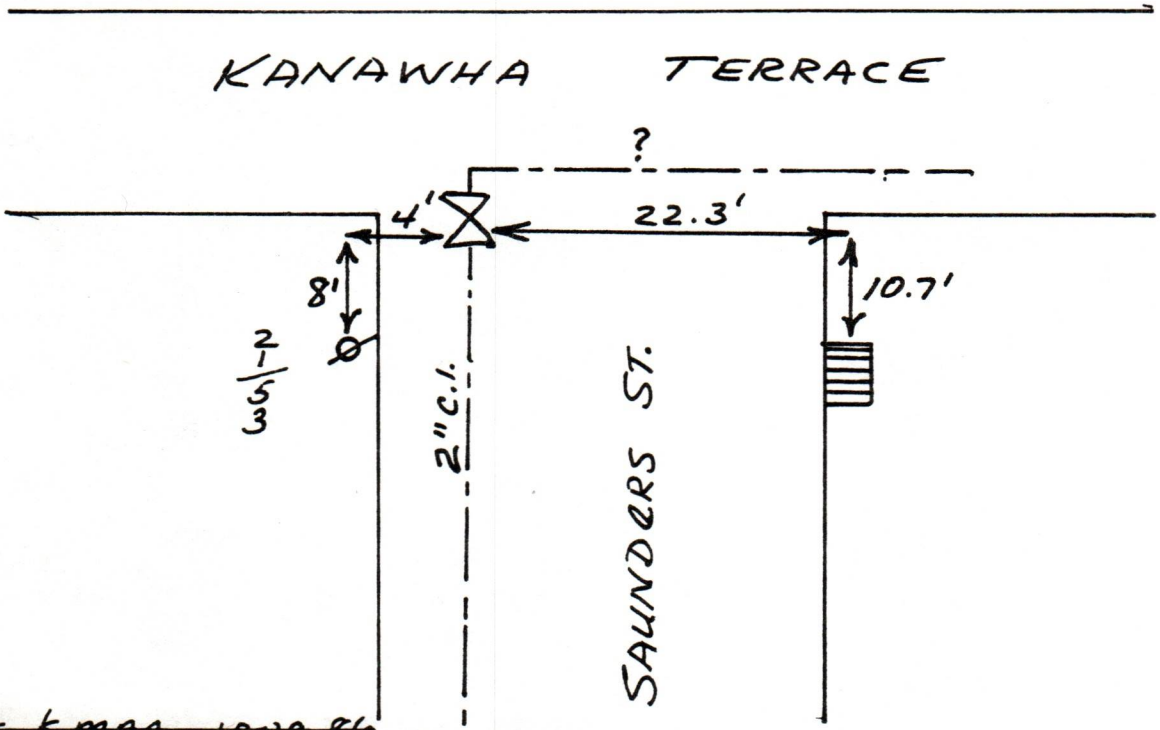

LOCATE 1/2 MAP 10-29-86