


N2W1

20-5

HANSFORD St.

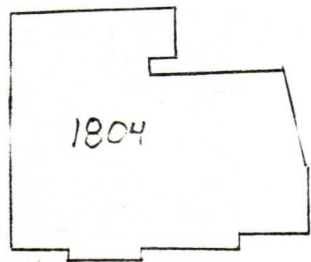

1804


ALLEY




1822

CUNNINGHAM St.

BENEDICT
CIRCLE

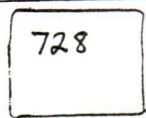

728

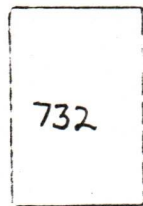

732



KANAWHA TERRACE