


NZW1

ts

Abney

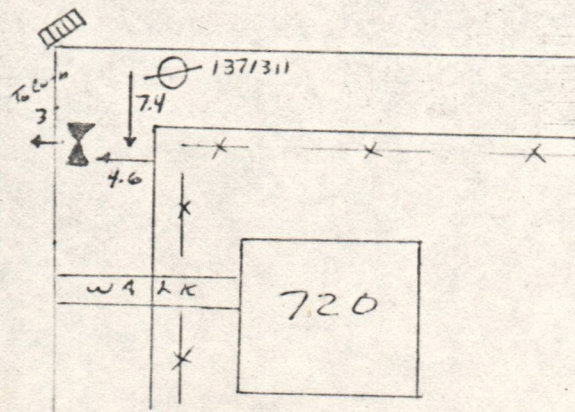

7-1