
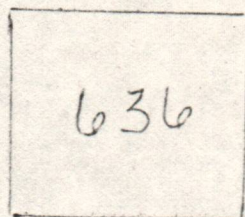
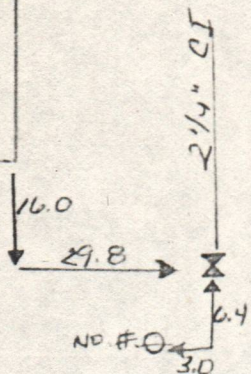


8-3

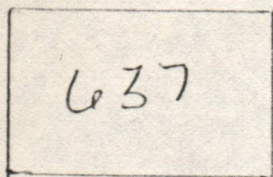

N2W1

7

HANSFORD

SEVENTH AVE

7