



NZW1



8-4

SEVENTH AVE.

E

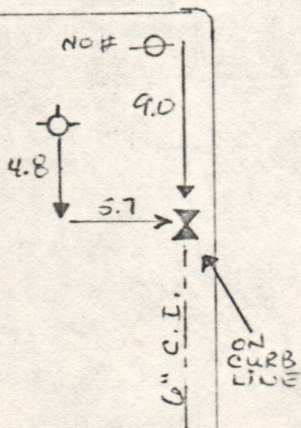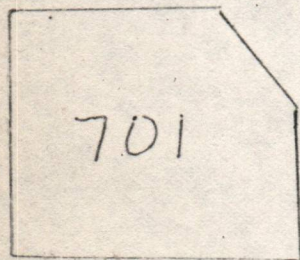

HANSFORD

CHURCH