


8-5

N2W1

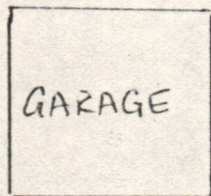

8.10


9.0

2" C.I.

ALLEY

4.50

CURB LINE

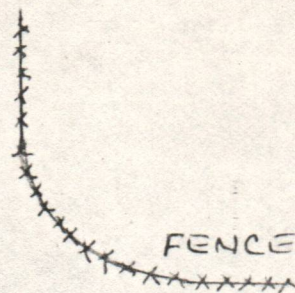

TO
HANSFORD
CHURCH PROP.

ALLEY

TO
CUNNINGHAM