


N2W2



19.0

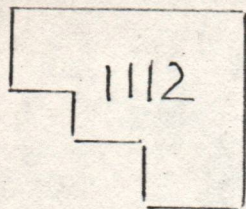

37B172

55

2" C.I.

5.9

HOLLEY STREET



1-1

KANAWHA

TERRACE

E