

22-4




N

N2W2

S. WASHINGTON


SUTHERLAND

SLATER AVE.

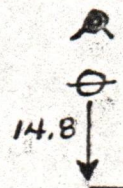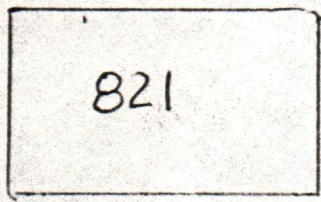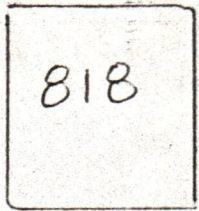

NO. #

34.3

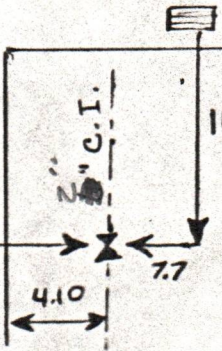

2" C.I.

4.10