

12-1

N2W3



1107  
KAN.  
TER.

PARK STREET

ALLEY


900'A'

3.9'

2" C.I.

ALLEY

12.4'

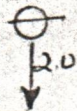

137B80

TO DREW ST →