




14-1

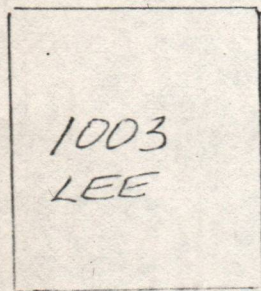

D.W.

LEE STREET

N2W3

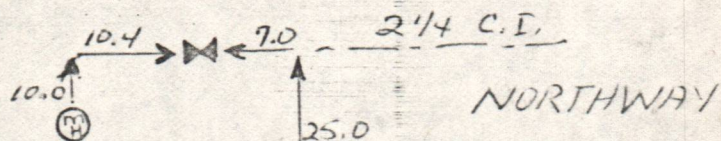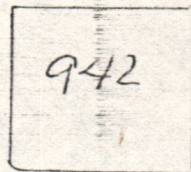

137B552

