

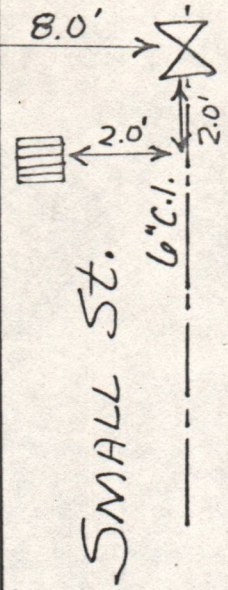
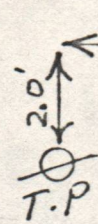


N2W3

16-1

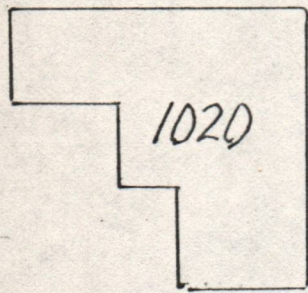

NORTHWAY

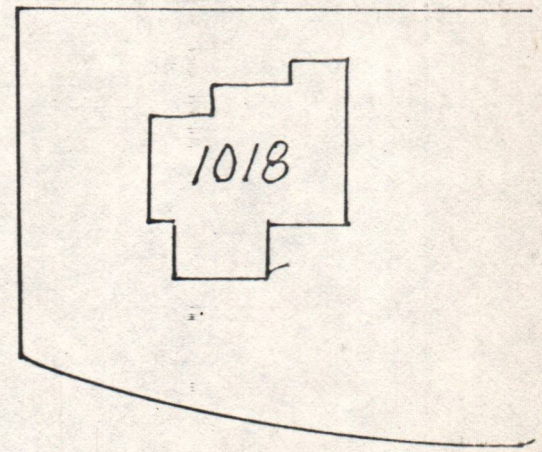

NORTHWAY

Edgehill