


22-2

N2W3

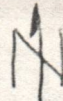

SMALL ST.


EDGEHILL

ALLEY

NORTHWAY

1013

620

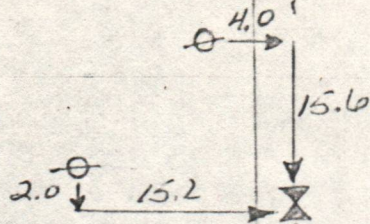

44.0

