


N2W3

22-3

SMALL ST.

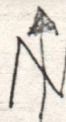

NORTHWAY DR.

EDGEHILL



6.6

17.6

11.0

59.6

Curbstop

2" C.E.

ALLEY

1013

620