

5-1

N2W3


KANAWHA TERRACE

ALLEY

ALLEY

807 A

2" C.I.

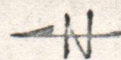

6.0

23.0

13.25

6.0

Small ST

