
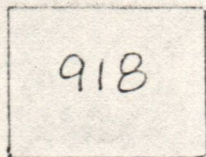


N2W3

9-1

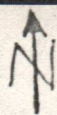

918

137B524



WEIMER STREET

31.0

22.5

LEE ST.

2 1/4" C.I.

38.75

35.0

LEE STREET

