


11-1



N2W4

WEIMER

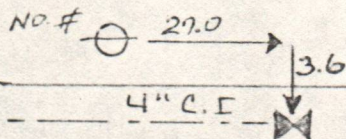

21.8

WEIMER AVE

60.4

EWALL

507

DIRT
ALLEY