


15-2

N

N2W4

HIGHLAWN ST.

10" C.I.

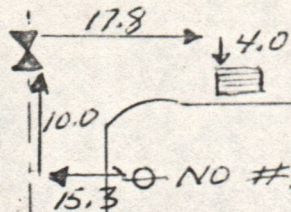

NANCY ST.

1076

1078