

NZW4

Highland


10" C.I.

136001

BURGESS
DRIVE

17'

2" C.I.

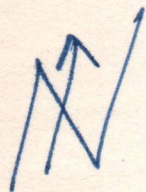

Gilchrist
DRIVE

DRIVE 10" C.I.

2-1