


N2 W5

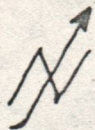

16-1

1

$\frac{2}{2}$

2" C.I.

28.7'

30.8'

SHERIDAN

LANE

2" P.V.C.

TO
MAPLE
LANE

GARAGE

1217