


N3E1

WEST STREET

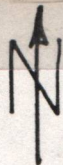

6" C.I.

TO WILSON


21-1

T.P.
2'

16.0'

9.0'

2" C.I.

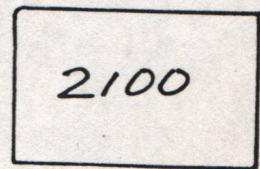

TO LINCOLN