




17-1

TO
GRANT

N3E2

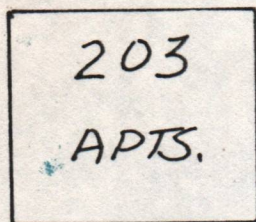

STREET

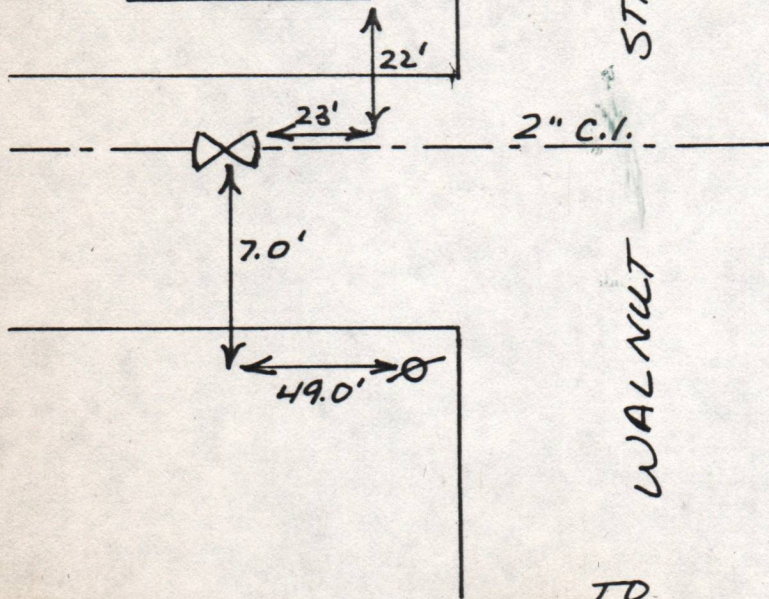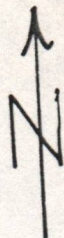

ALLEY

WALNUT

TO
MCKINLEY