


17-4

TO GRANT

N3E2

203
APTS.

WALNUT

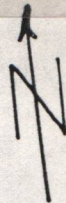

ALLEY

