


N3E2

N

23-1

McKinley

St.

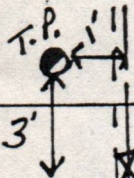

2" C.I.

ALLEY

Walnut

321

ADAMS

