

6-1

TO CLEVELAND ↗




N3E2

WALNUT

2" C.I.

2" GAL.

ALLEY

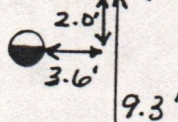

9.3'

32.8'

1370528

TO HARRISON ↘