


6-3

N3E2

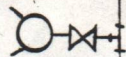

CLEVELAND AVE.

CLEVELAND AVE.

6" D.I.

Walnut St.



24'

6" C.I.

Hydrant use to be
HERE UNTIL line was
Extended.