


N3E3


N

KNOX

15-2

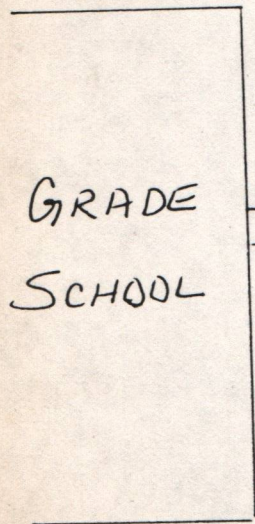

PF AFF STREET

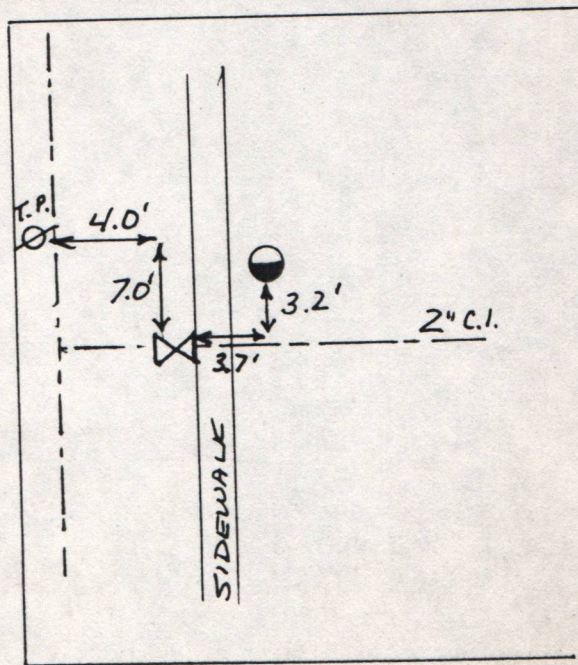

FORRESTAL