

N3E3




BARD AVE.

20-1

CITY
TENNIS
COURTS

PEAFF STREET

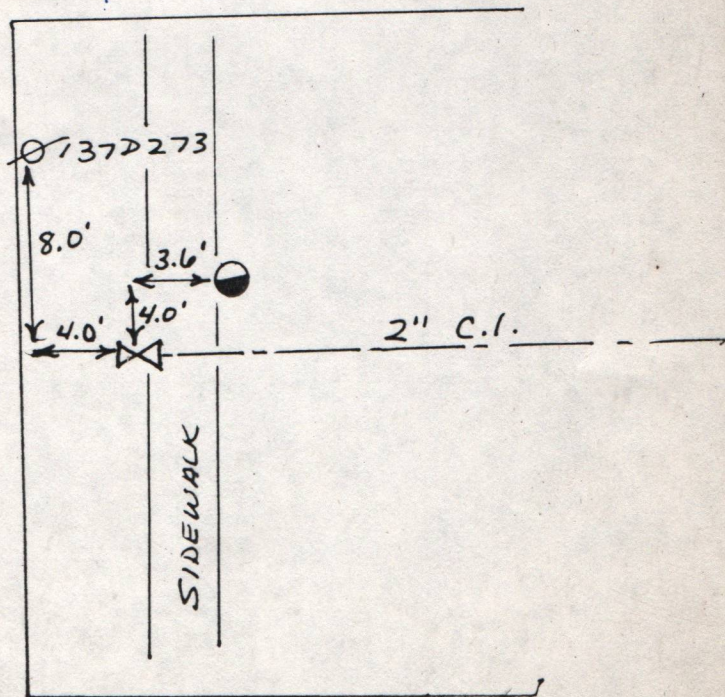

FURLONG AVE.