


N3E3

KNOX



AVENUE

24-1

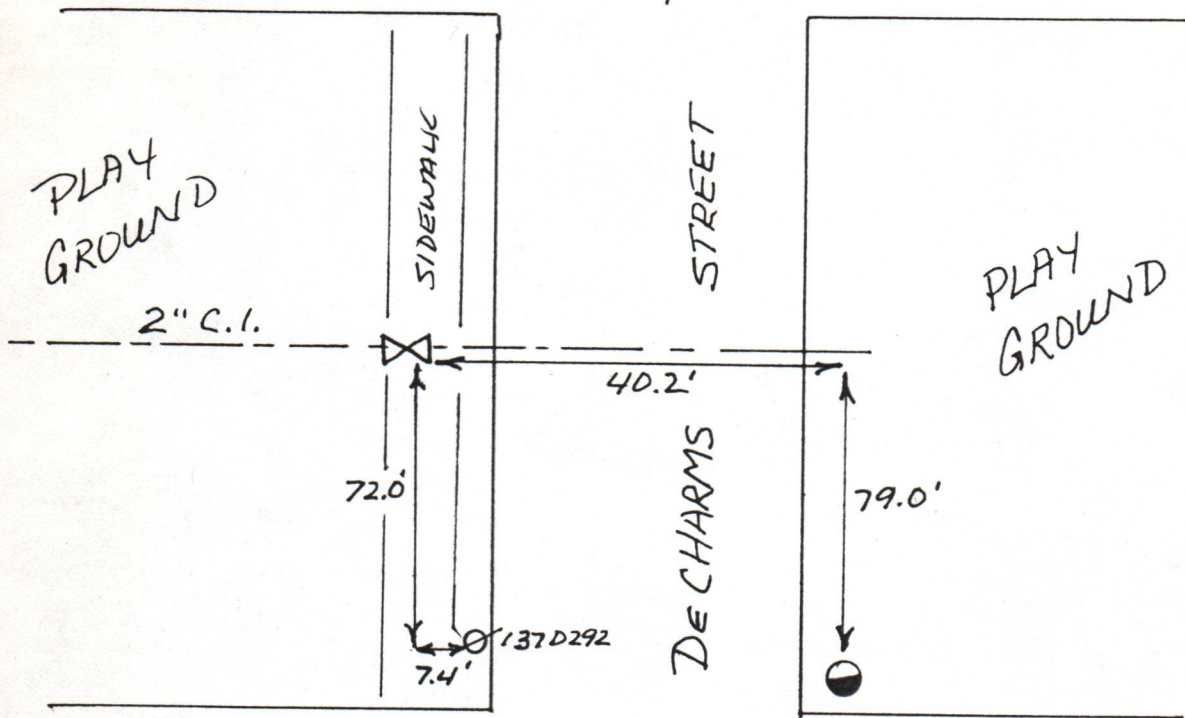

FORRESTAL

AVENUE