


N3E3

ROOSEVELT AVE.

18-1

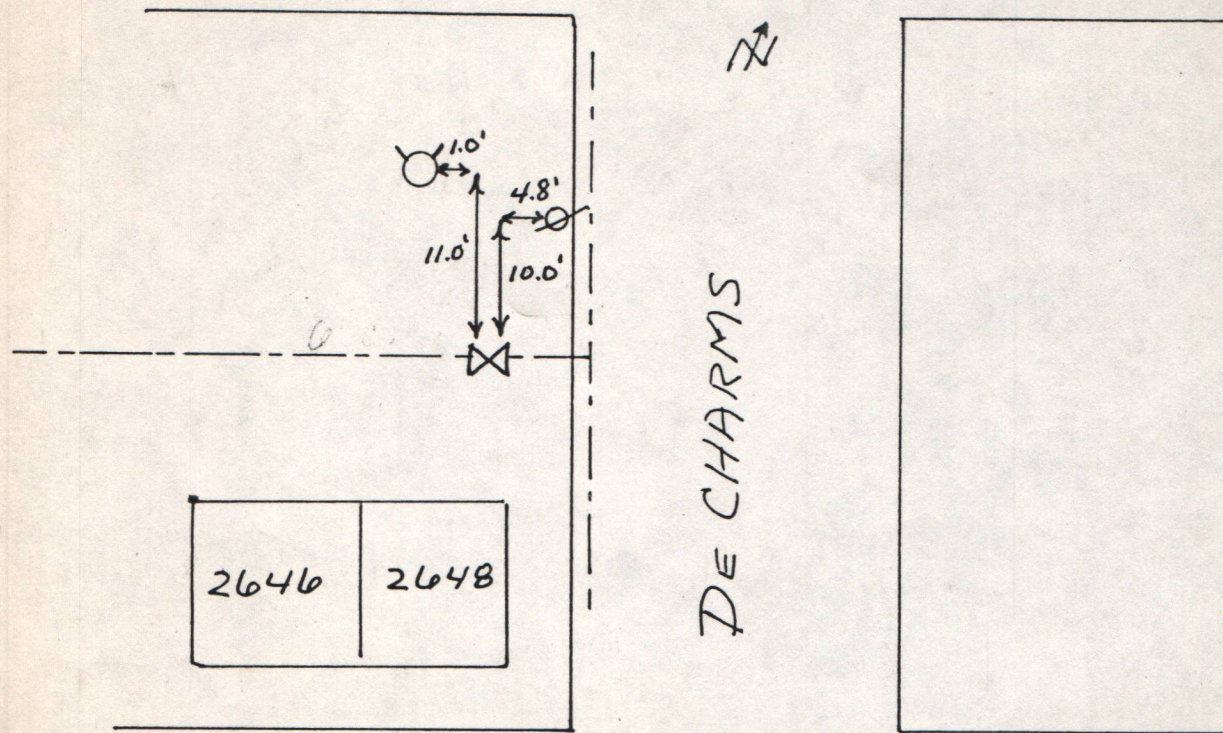

KNOX AVE.